


1 FIRST LEVEL PLAN
SCALE: 1/4" = 1'-0"

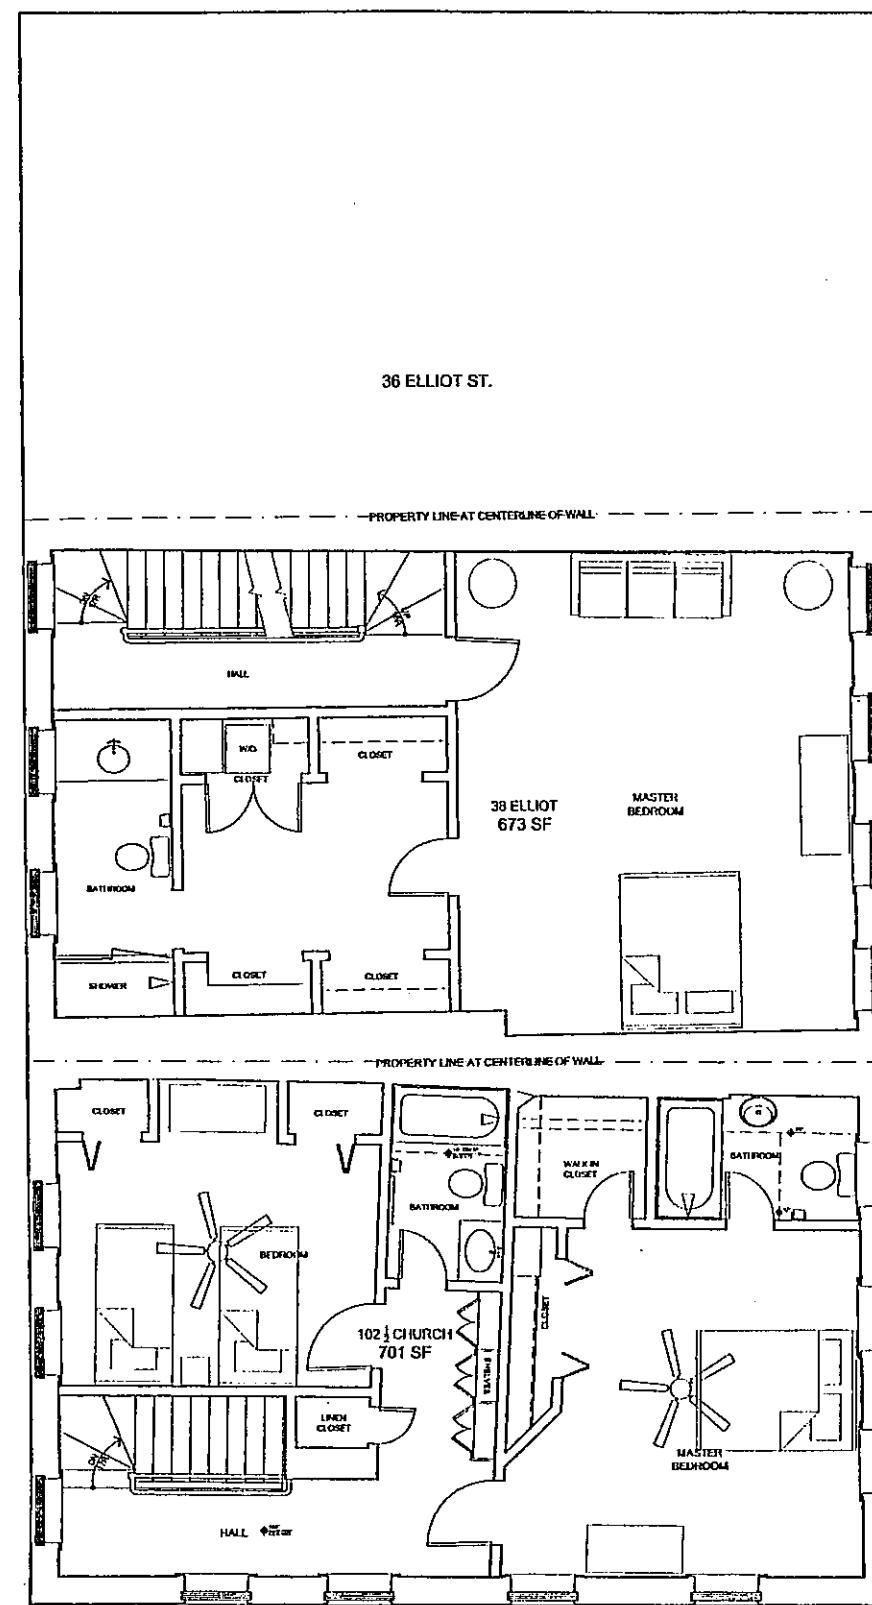

2 SECOND LEVEL PLAN
SCALE: 1/4" = 1'-0"

GCE - GENERAL COMMON ELEMENT
LCE A- LIMITED COMMON ELEMENT TO UNIT A
LCE B- LIMITED COMMON ELEMENT TO UNIT B

THE UNDERSIGNED DOES CERTIFY THAT THESE PLANS ACCURATELY REFLECT THE LOCATION, AREA AND DIMENSIONS OF THE UNITS AND THE LCE AND GCE AFFORD ACCESS TO THE UNITS TO THE BEST OF MY KNOWLEDGE.


THESE DOCUMENTS REFLECT, TO THE BEST OF THE ARCHITECTS' ABILITY, THE OBSERVABLE AND ACCESSIBLE AS-BUILT GRAPHIC CONFIGURATION OF THE STRUCTURES AS MEASURED BY EVANS AND SCHEIDT ARCHITECTS. ADDITIONAL INFORMATION TAKES PRECEDENT OVER GRAPHICAL INFORMATION. THESE DOCUMENTS DO NOT REPRESENT OR IMPLY THAT THE AS BUILT CONFIGURATION IS IN COMPLIANCE WITH CURRENT BUILDING CODES OR REGULATORY AGENCY REQUIREMENTS.

CHURCH & ELLIOT STREET

START OF
REVISION
START OF
REVISION

revision:
project:
date: 10
drawn by:
checked:

E

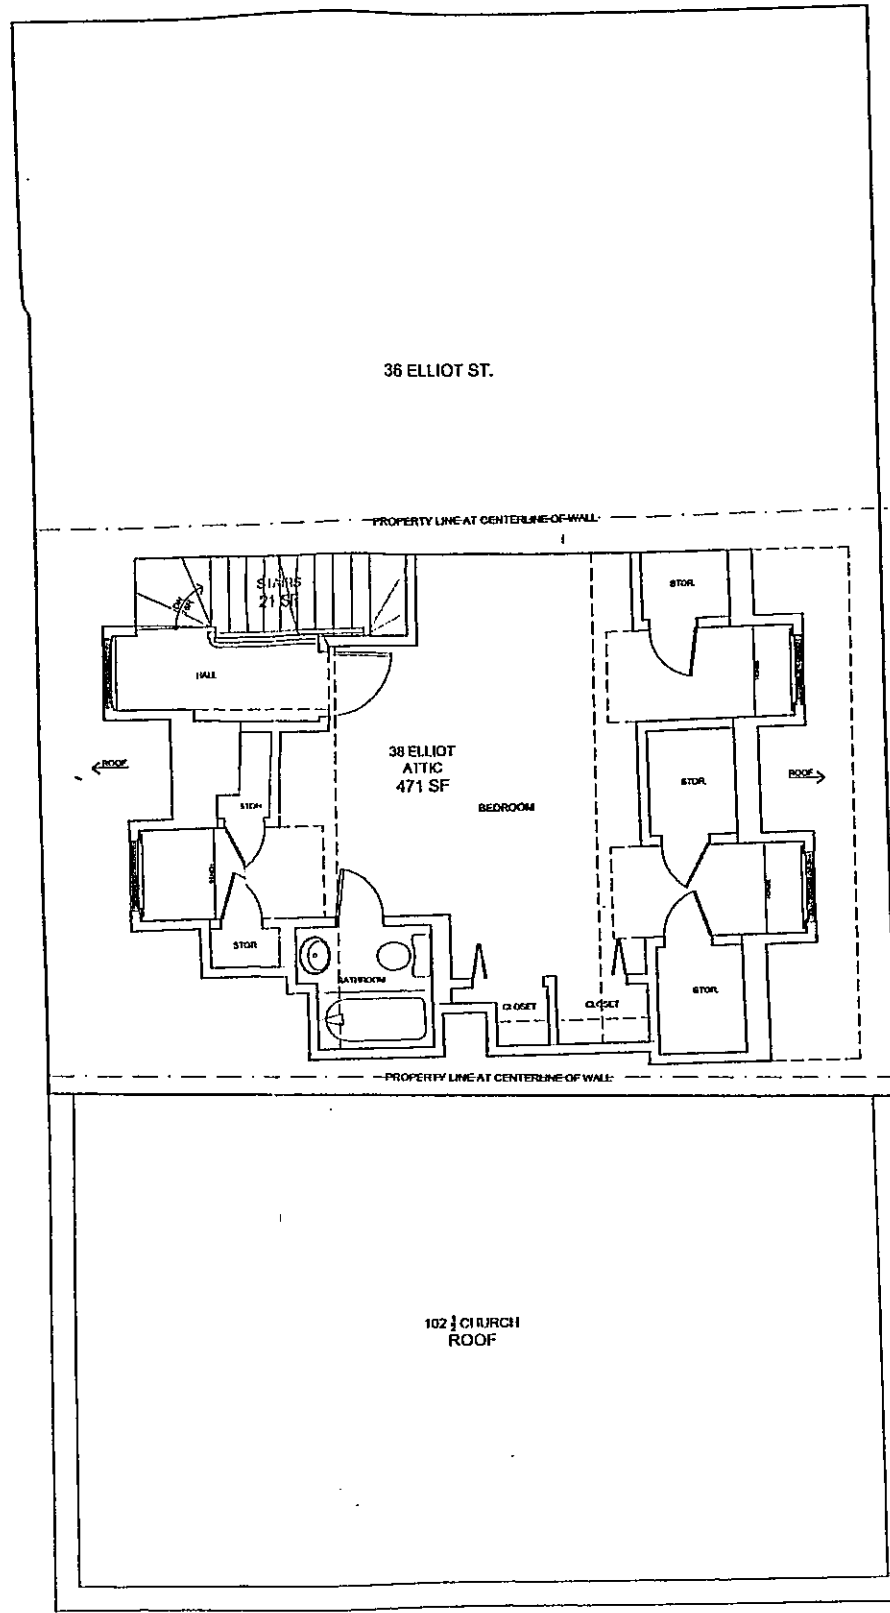

36 ELLIOT ST.

PROPERTY LINE AT CENTERLINE OF WALL

38 ELLIOT
ATTIC
471 SF

PROPERTY LINE AT CENTERLINE OF WALL

102 CHURCH
ROOF

GCE - GENERAL COMMON ELEMENT
LCE A- LIMITED COMMON ELEMENT TO UNIT A
LCE B- LIMITED COMMON ELEMENT TO UNIT B


THE UNDERSIGNED DOES CERTIFY THAT THESE PLANS ACCURATELY REFLECT THE LOCATION, AREA AND DIMENSIONS OF THE UNITS AND THE LCE AND GCE AFFORD ACCESS TO THE UNITS TO THE BEST OF MY KNOWLEDGE.

THESE DOCUMENTS REFLECT, TO THE BEST OF THE ARCHITECTS' ABILITY, THE OBSERVABLE AND ACCESSIBLE AS-BUILT GRAPHIC CONFIGURATION OF THE STRUCTURES AS MEASURED BY EVANS AND SCHMIDT ARCHITECTS. DIMENSIONAL INFORMATION TAKES PRECEDENT OVER GRAPHICAL INFORMATION. THESE DOCUMENTS DO NOT REPRESENT OR IMPLY THAT THE AS-BUILT CONFIGURATION IS IN COMPLIANCE WITH CURRENT BUILDING CODES OR REGULATORY AGENCY REQUIREMENTS.

1 ROOF/ATTIC PLAN
SCALE: 1/4" = 1'-0"

EVANS & SCHMIDT ARCHITECTS
204 MEETING STREET, CHARLESTON, S.C. 29401 (843) 733-5495

CHURCH & ELLIOT STREET
HORIZONTAL PROPERTY REGIME
CHARLESTON, SOUTH CAROLINA

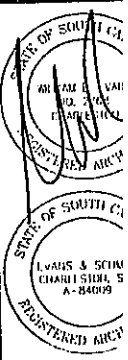


revisions:

project number: 0
date: 10.11.2007
drawn by: JCM
checked by: WDE

EX1.:



1 COURTYARD ELEVATION
SCALE: 1/4" = 1'-0"

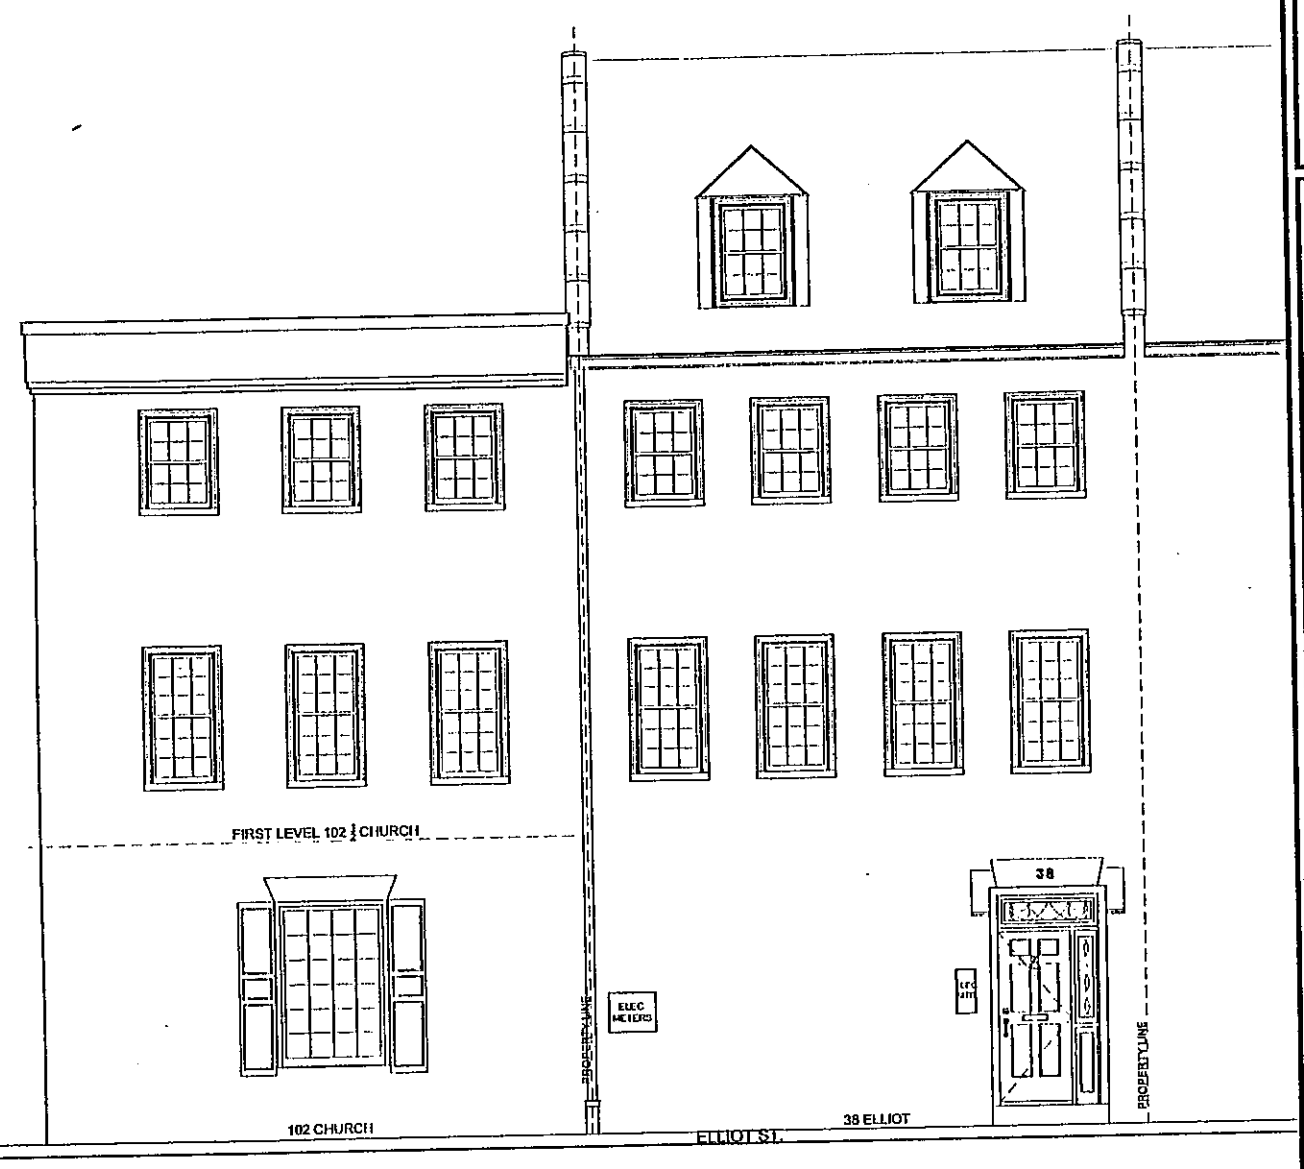

2 ELLIOT ST. ELEVATION
SCALE: 1/4" = 1'-0"

GCE - GENERAL COMMON ELEMENT
LCE A- LIMITED COMMON ELEMENT TO UNIT A
LCE B- LIMITED COMMON ELEMENT TO UNIT B

THE UNDERSIGNED DOES CERTIFY THAT THESE PLANS ACCURATELY REFLECT THE LOCATION, AREA AND DIMENSIONS OF THE UNITS AND THE LCE AND GCE AFFORD ACCESS TO THE UNITS TO THE BEST OF MY KNOWLEDGE.

THESE DOCUMENTS REFLECT, TO THE BEST OF THE ARCHITECTS' ABILITY, THE OBSERVABLE AND ACCESSIBLE AS-BUILT GRAPHIC CONFIGURATION OF THE STRUCTURES AS MEASURED BY EVANS AND SCHMIDT ARCHITECTS. DIMENSIONAL INFORMATION TAKES PRECEDENCE OVER GRAPHICAL INFORMATION. THESE DOCUMENTS DO NOT REPRESENT OR IMPLY THAT THE AS-BUILT CONFIGURATION IS IN COMPLIANCE WITH CURRENT BUILDING CODES OR REGULATORY AGENCY REQUIREMENTS.

THESE DOCUMENTS REFLECT, TO THE BEST OF THE ARCHITECTS' ABILITY, THE OBSERVABLE AND ACCESSIBLE AS-BUILT GRAPHIC CONFIGURATION OF THE STRUCTURES AS MEASURED BY EVANS AND SCHMIDT ARCHITECTS. DIMENSIONAL INFORMATION TAKES PRECEDENCE OVER GRAPHICAL INFORMATION. THESE DOCUMENTS DO NOT REPRESENT OR IMPLY THAT THE AS-BUILT CONFIGURATION IS IN COMPLIANCE WITH CURRENT BUILDING CODES OR REGULATORY AGENCY REQUIREMENTS.

